


AMOVICE

616200
1181650

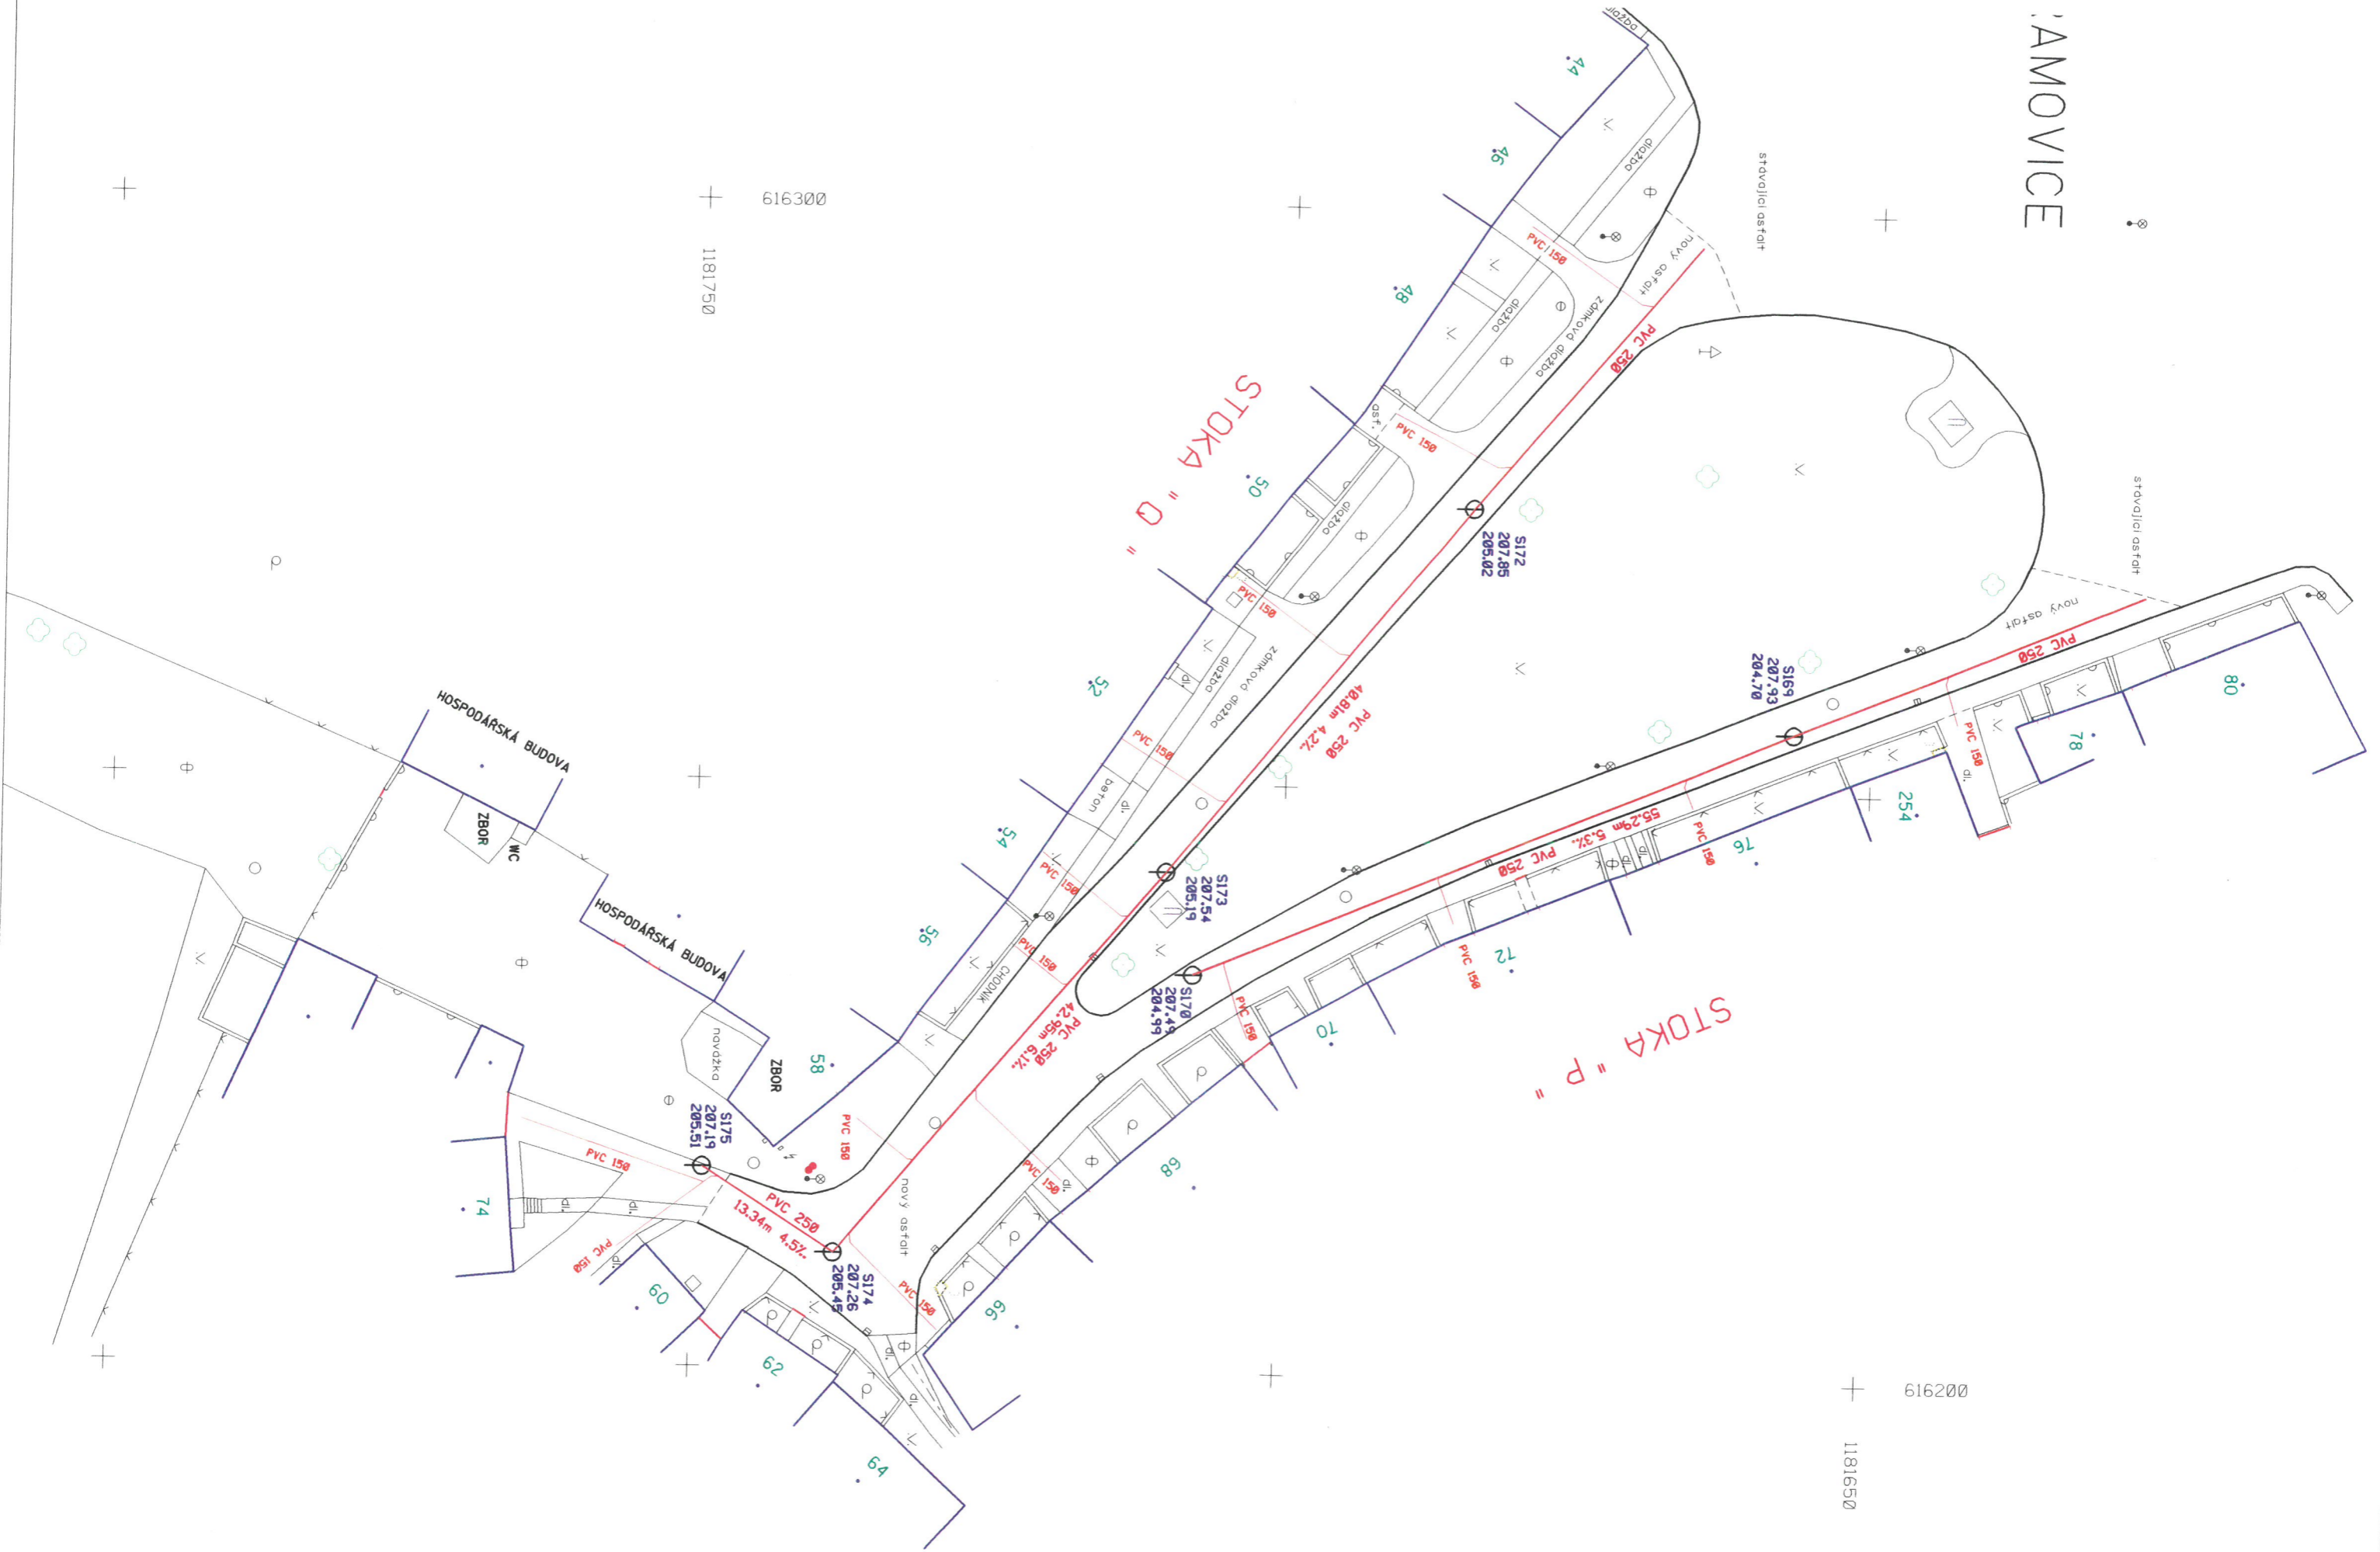

+

616300
1181750

+

+